

ETHIRAJ COLLEGE FOR WOMEN (Autonomous)
Chennai – 600 008

Affiliated to the University of Madras
College with Potential for Excellence
Re-accredited with A+ Grade by NAAC




4.1 PHYSICAL FACILITIES

**4.1.1 INFRASTRUCTURE AND PHYSICAL
FACILITIES FOR TEACHING-LEARNING**


(Topographical Survey Map of Ethiraj College)

**TOPOGRAPHICAL SURVEY AT ETHIRAJ COLLEGE FOR WOMEN
ETHIRAJ SALAI, EGMORE, CHENNAI.**

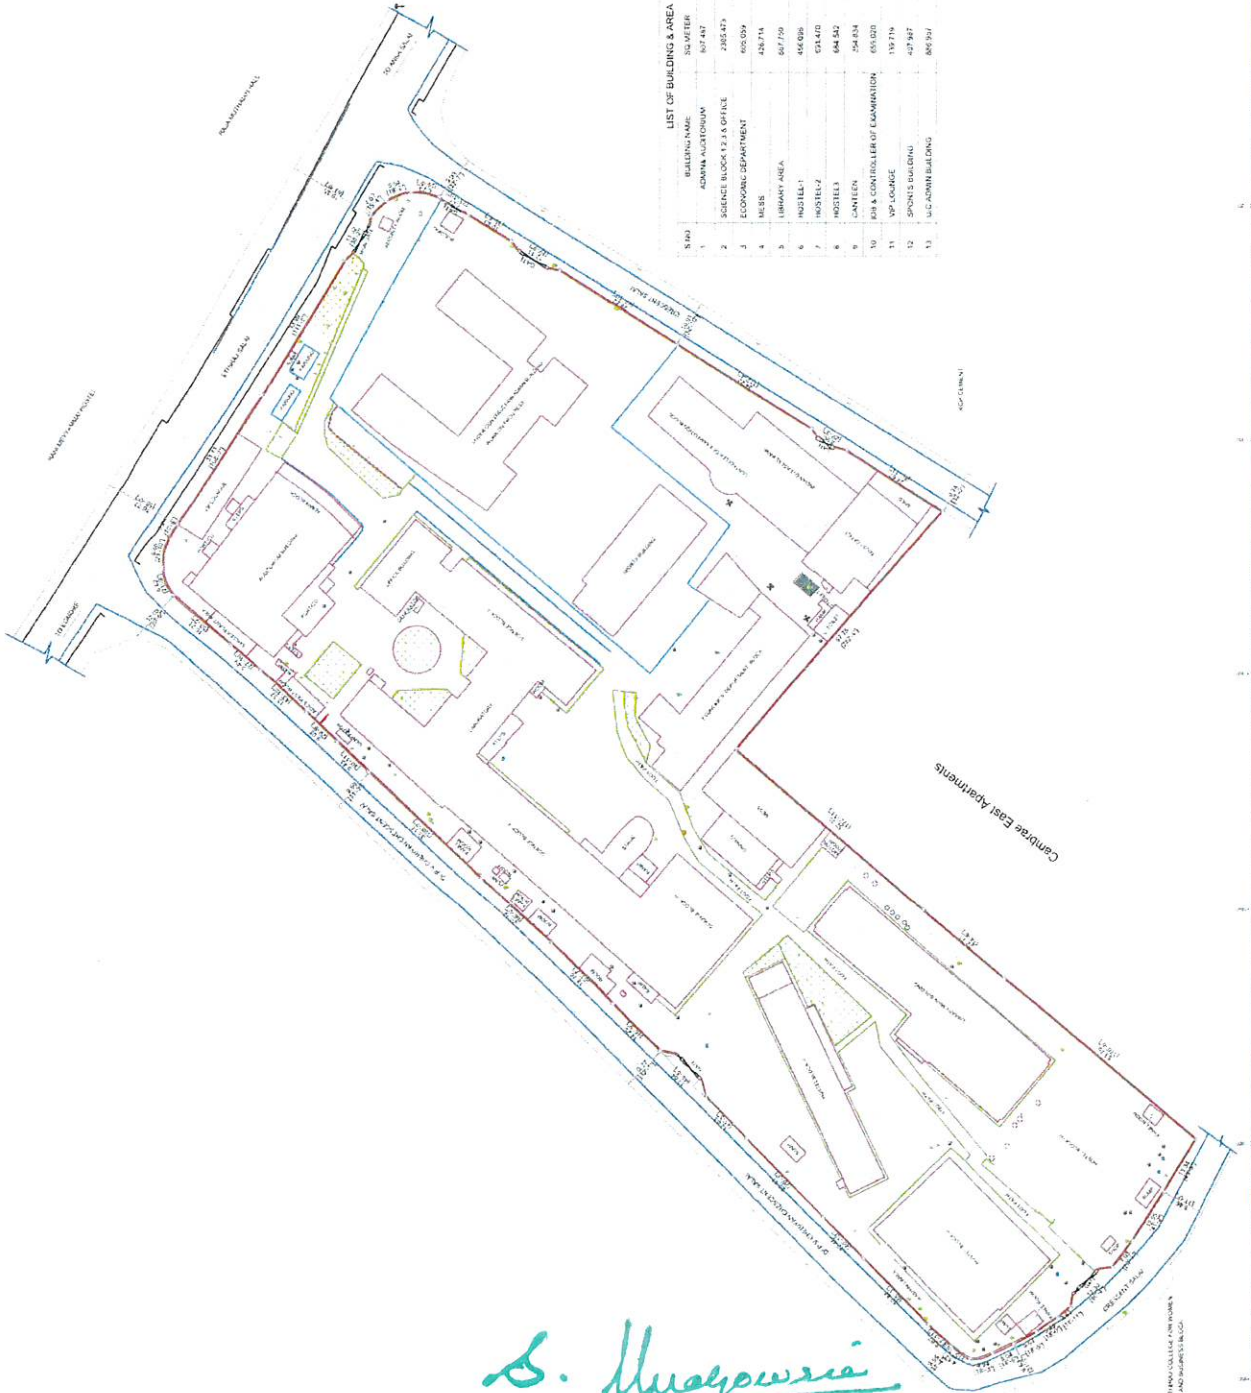

LIST OF BUILDING & AREA

Sl No	Building Name	Sl No	Area in Sq. Meters
1	ADMIN BLDG	101-107	4916.111
2	SCIENCE BLOCK 1 & 2	201-207	4916.111
3	ECONOMIC DEPARTMENT	301-307	4916.111
4	MESS	401-407	4916.111
5	LIBRARY AREA	501-507	4916.111
6	HOSTEL 1	601-607	4916.111
7	HOSTEL 2	701-707	4916.111
8	CANTEEN	801-807	4916.111
9	SPORTS GROUND	901-907	4916.111
10	WATER TOWER	1001-1007	4916.111
11	WATER TOWER	1101-1107	4916.111
12	WATER TOWER	1201-1207	4916.111
13	WATER TOWER	1301-1307	4916.111

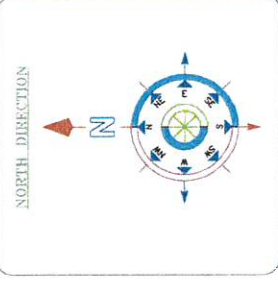

LEGEND:-

- Water
- Concrete
- Asphalt
- Gravel
- Soil
- Vegetation
- Boundary
- Survey Line
- Control Point
- Leveling Station
- Reference Point
- Spot Height
- Reduced Level
- Original Ground
- Proposed Ground
- Contours
- Spot Level
- Spot Height
- Reduced Level
- Original Ground
- Proposed Ground
- Contours
- Spot Level
- Spot Height
- Reduced Level
- Original Ground
- Proposed Ground
- Contours

AREA DETAILS:-
DESCRIPTION: AREA IN ACRES
TOTAL AREA OF THE SITE: 22657.651 5.508

NOTES:-
1. SURVEY DONE DURING JULY-2022
2. ALL DIMENSIONS ARE IN METERS (AS PER THE LIST)
3. SURVEY BOUNDARY IS IDENTIFIED BY THE LIST

PROJECT TITLE:-
TOPOGRAPHICAL SURVEY AT ETHIRAJ COLLEGE FOR WOMEN CHENNAI.


CLIENT:-
XXXXXXXXXXXXXXXXXXXX
XXXXXXXXXXXXXXXXXXXX
XXXXXXXXXXXXXXXXXXXX

SURVEYED BY:-
RELIABLE CONSULTANTS
G.I.S. LAND MAPPING
RECEIVED: PLOT NO.109/A, 2ND STREET, LAKSHMI NAGAR,
CHENNAI-600 042, INDIA
MOBILE: 9840050000, 9840050001
EMAIL: info@reliableconsultants.com
www.reliableconsultants.com

Model No. R.S. 109/A 14.07.2022 01 08
FILE NAME: E:\2022\109\A\ETHIRAJ COLLEGE

S. Mageswari
PRINCIPAL
ETHIRAJ COLLEGE FOR WOMEN
(AUTONOMOUS)
CHENNAI-600 008.

TOPOGRAPHICAL SURVEY AT ETHIRAJ COLLEGE FOR WOMEN CAMPUS-II, EGMORE, CHENNAI.

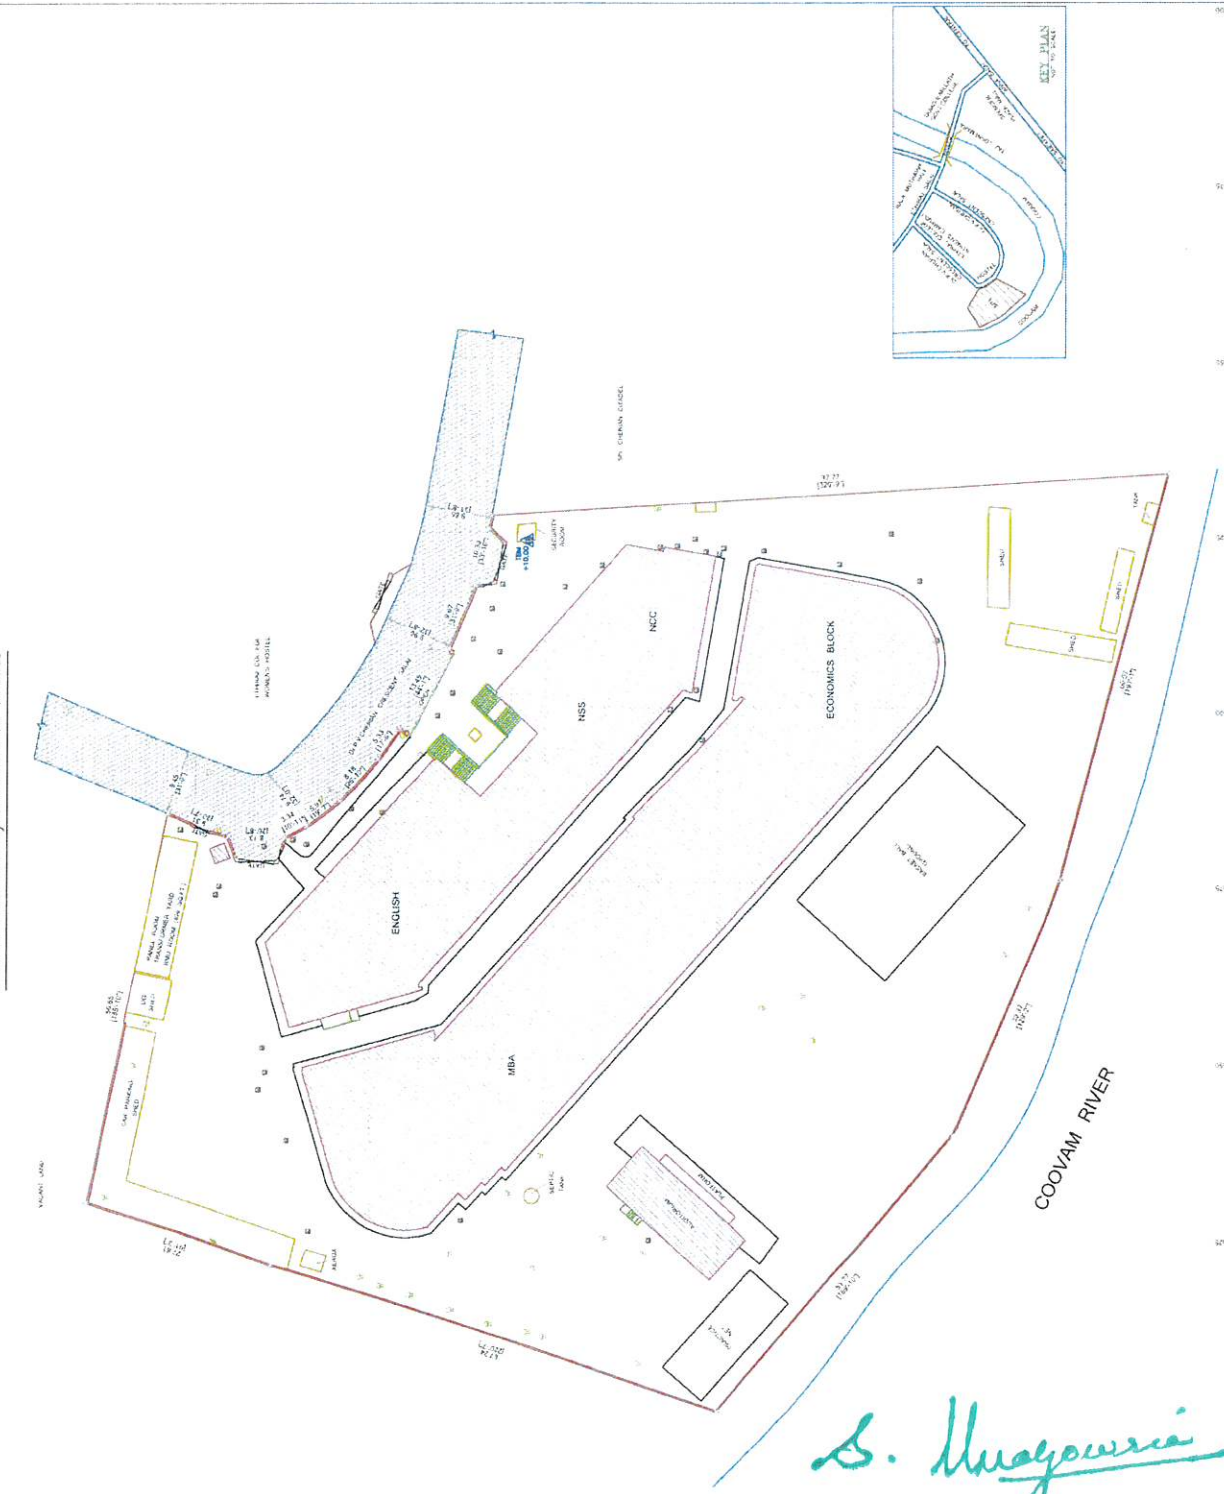

S. Mageswari
 PRINCIPAL
 ETHIRAJ COLLEGE FOR WOMEN
 (AUTONOMOUS)
 CHENNAI-600 008.



LEGEND:-

Symbol	Description
Red line	Boundary
Blue line	Water
Green area	Vegetation
Black outline	Building
Yellow outline	Open area
Grey outline	Security fence
Circle with cross	Survey station
Circle with dot	Reference point
Circle with crosshair	Level point
Circle with 'x'	Spot height
Circle with 'y'	Reduced level
Circle with 'z'	Contour interval
Circle with 'a'	Contour line
Circle with 'b'	Contour interval
Circle with 'c'	Contour line
Circle with 'd'	Contour interval
Circle with 'e'	Contour line
Circle with 'f'	Contour interval
Circle with 'g'	Contour line
Circle with 'h'	Contour interval
Circle with 'i'	Contour line
Circle with 'j'	Contour interval
Circle with 'k'	Contour line
Circle with 'l'	Contour interval
Circle with 'm'	Contour line
Circle with 'n'	Contour interval
Circle with 'o'	Contour line
Circle with 'p'	Contour interval
Circle with 'q'	Contour line
Circle with 'r'	Contour interval
Circle with 's'	Contour line
Circle with 't'	Contour interval
Circle with 'u'	Contour line
Circle with 'v'	Contour interval
Circle with 'w'	Contour line
Circle with 'x'	Contour interval
Circle with 'y'	Contour line
Circle with 'z'	Contour interval

AREA DETAILS:-
 DESCRIPTION: AREA IN ACRES
 TOTAL AREA OF THE SITE: 141178.593 3.241

NOTES:-
 1. SURVEY DONE DURING JAN-2023
 2. ALL DIMENSIONS ARE IN METRE AND (MPT)
 3. BENCH MARK IS BASED ON THE FLOOR LEVEL OF SECURITY SHED AND THIS VALUE IS 100.000
 4. SURVEYED BOUNDARY AUTHENTICATED BY THE CLIENT

PROJECT TITLE:
**TOPOGRAPHICAL SURVEY AT
 ETHIRAJ COLLEGE**

CLIENT:
**M/S SAI HARE,
 CHENNAI.**

SURVEYED BY:
**RELIABLE CONSULTANTS
 GIS PLANNING
 RET. OFT: PLOT NO.105/A, 5th STREET, LAKSHMI NAGAR
 MADURAI - CHENNAI-600 031
 PHONE: 9840200000/9840200202
 EMAIL: reliableconsultants@gmail.com
 WEB: www.reliableconsultants.com**

DATE	14/01/2023	SCALE	1:1000
DRAWN BY	S. MAGESWARI	CHECKED BY	S. MAGESWARI
DATE	14/01/2023	SCALE	1:1000
DRAWN BY	S. MAGESWARI	CHECKED BY	S. MAGESWARI
DATE	14/01/2023	SCALE	1:1000
DRAWN BY	S. MAGESWARI	CHECKED BY	S. MAGESWARI

